


GROUND ELEVATION				
INVERT ELEVATION	35.85	37.47	39.01	40.29

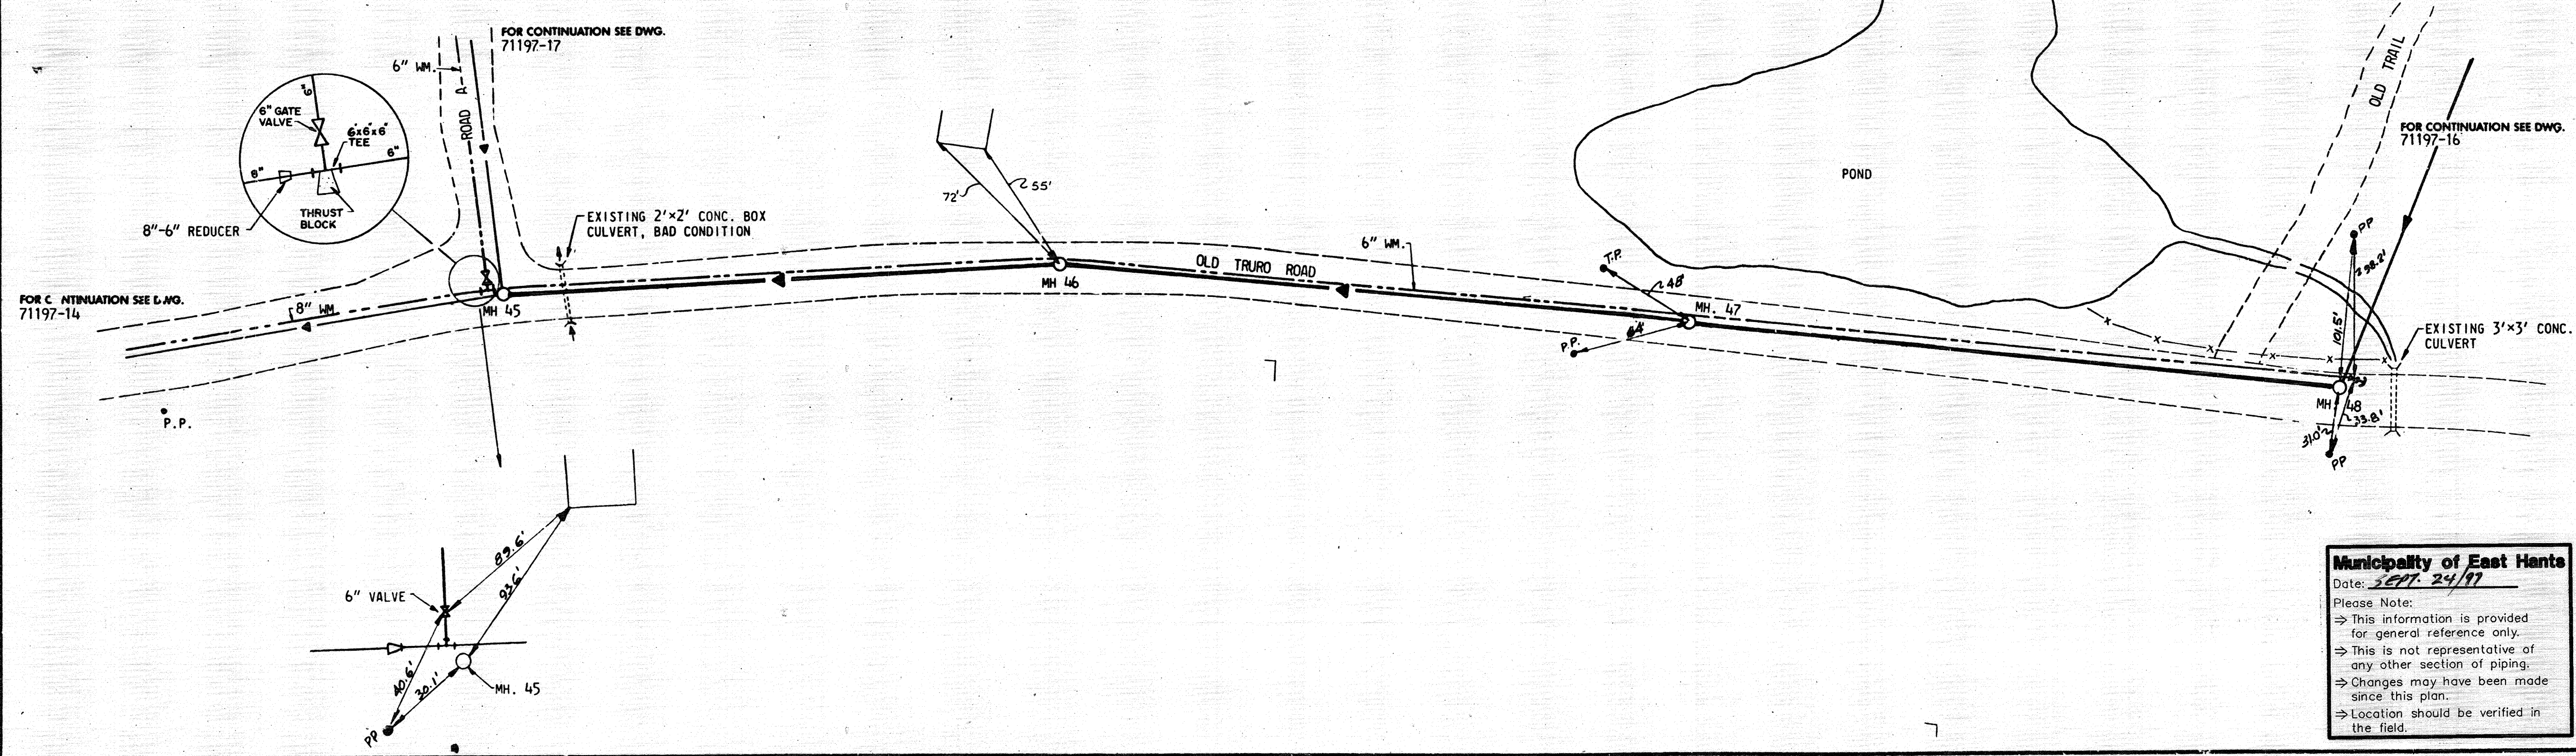

2 AS CONSTRUCTED
1 ISSUED FOR TENDER
02 REISSUED FOR APPROVAL
01 ISSUED FOR APPROVAL

NO.	DESCRIPTION	DATE	BY
2	AS CONSTRUCTED	6/26/97	W.A. MacRae
1	ISSUED FOR TENDER	9/4/97	W.A. MacRae
02	REISSUED FOR APPROVAL	10/27/97	W.A. MacRae
01	ISSUED FOR APPROVAL	10/27/97	W.A. MacRae

REVISION OR ISSUE
THIS DRAWING SHOWS WORK AS CONSTRUCTED
DATE January 8, 1996
APPROVED L.C. Webb P.E.
CANADIAN - BRITISH CONSULTANTS LIMITED
MUNICIPALITY OF EAST HANTS
MUNICIPAL SERVICES - LANTZ
M.H. 45 TO M.H. 48
CBCI
CANADIAN - BRITISH CONSULTANTS LIMITED
HALIFAX N.S. V1A 1A1
DATE: JUL 1/92 SCALE: HOR. 1"=40', VERT. 1"=4'

Municipality of East Hants
Date: SEPT. 24/97
Please Note:
⇒ This information is provided for general reference only.
⇒ This is not representative of any other section of piping.
⇒ Changes may have been made since this plan.
⇒ Location should be verified in the field.

DRAWN BY
W.A. MacRae
CHECKED BY
W.A. MacRae
CONTRACT No.
71197
DRAWING NUMBER
71197-13

DESIGNED BY
N.A.H.
APPROVED BY
W.A. MacRae
SHEET
16 of 34
REV.
1