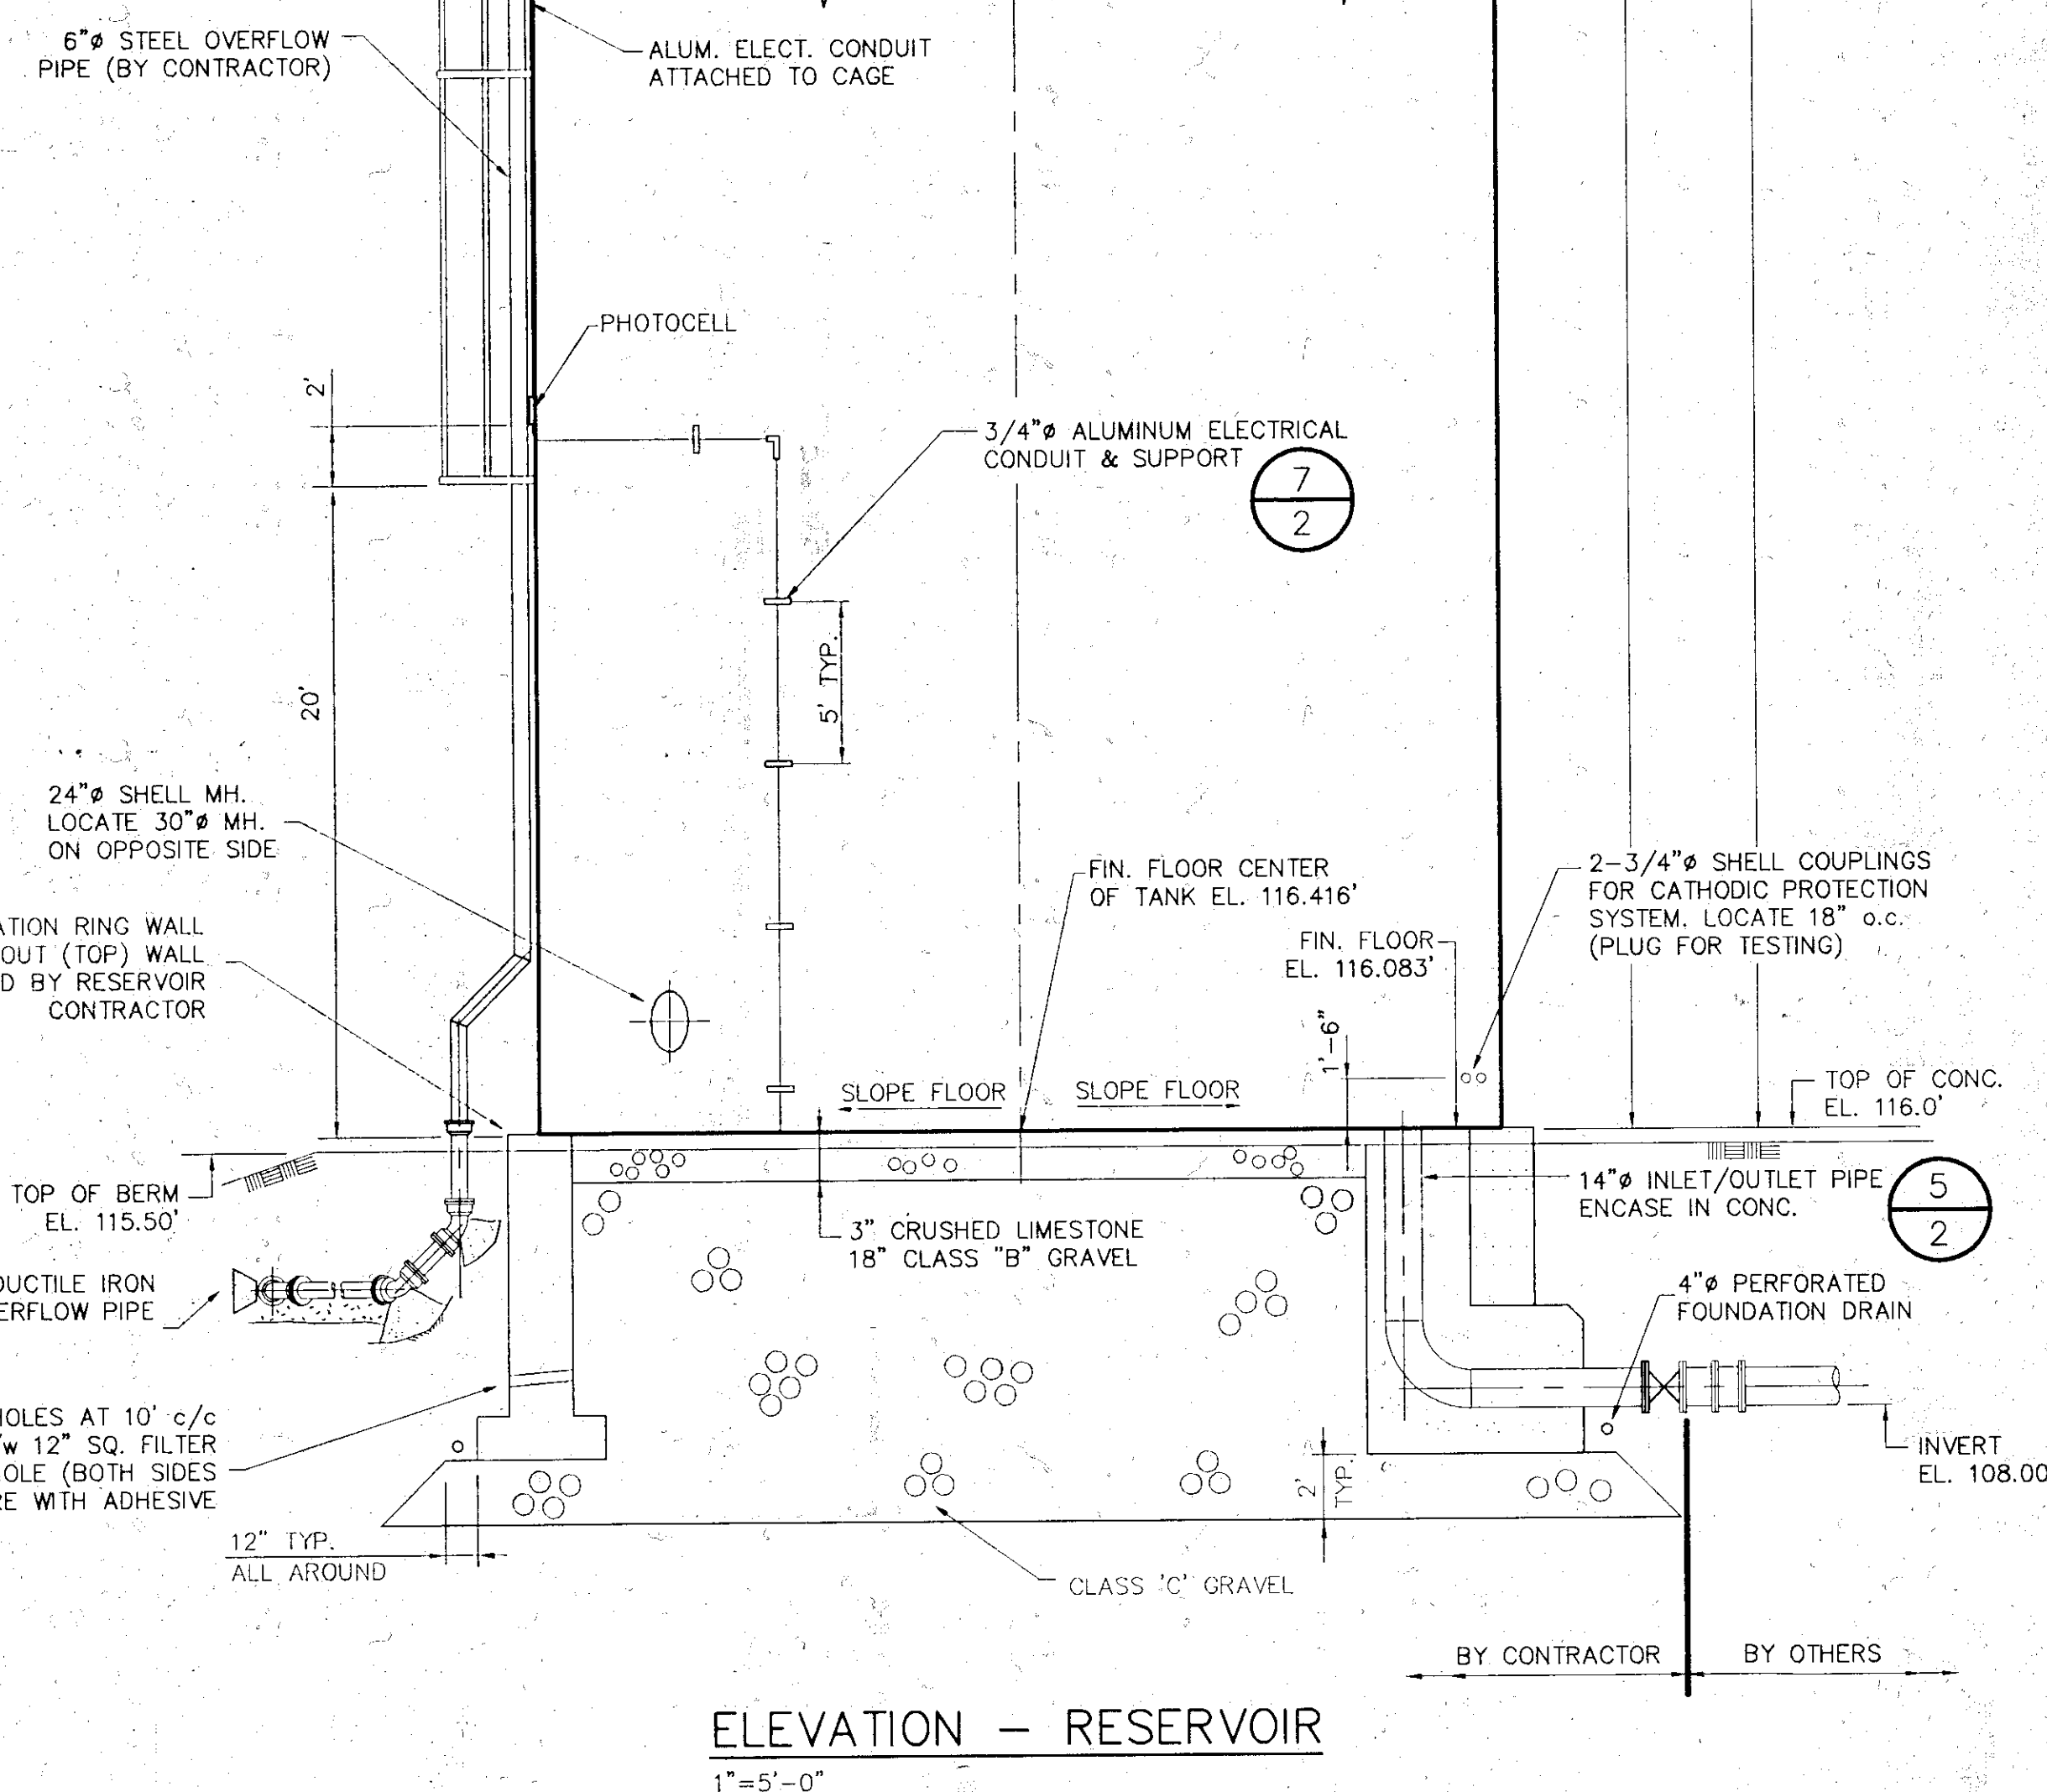
[illegible]

ELEVATION - RESERVOIR  
1"=5'-0"

Date: SEPT. 24/97

Please Note:

- This information is provided for general reference only.
- This is not representative of any other section of piping.
- Changes may have been made since this plan.
- Location should be verified in the field.

03	RECORD DRAWING	09/10/91	S.G.
1	OVERFLOW MANHOLE ADDED TO THIS CONTRACT. REVISED OUTCALL		
02	ISSUED FOR TENDER	09/08/89	D.C.
01	ISSUED FOR APPROVAL	09/08/89	D.C.
No.	Description	Date	By
Revision or Issue			

## Record drawing

Date SEPT. 10 1991  
Approved [Signature] P.Eng

MUNICIPALITY OF EAST HANTS  
LANTZ RESERVOIR

## RESERVOIR LAYOUT AND SITE PLAN

**CBCL** CBCL Limited  
Consulting Engineers

Scale AS NOTED

	Date	JULY 1989	Drawn	J.D.L.
	Designed	Checked	Approved	
	A.G.			
	Contract No	86549J	Sheet of	1 / 4
	Drawing No		Revision	
		1		1