

1	Record Information Added	GAR
No.	Revision	Ckd By
		Nov. 2011
		Date


RECORD DRAWING

HORNER
ASSOCIATES LIMITED
consulting and design engineers

89 Queen Street
Turro, NS


Adi

© 2007 Horner Associates Limited


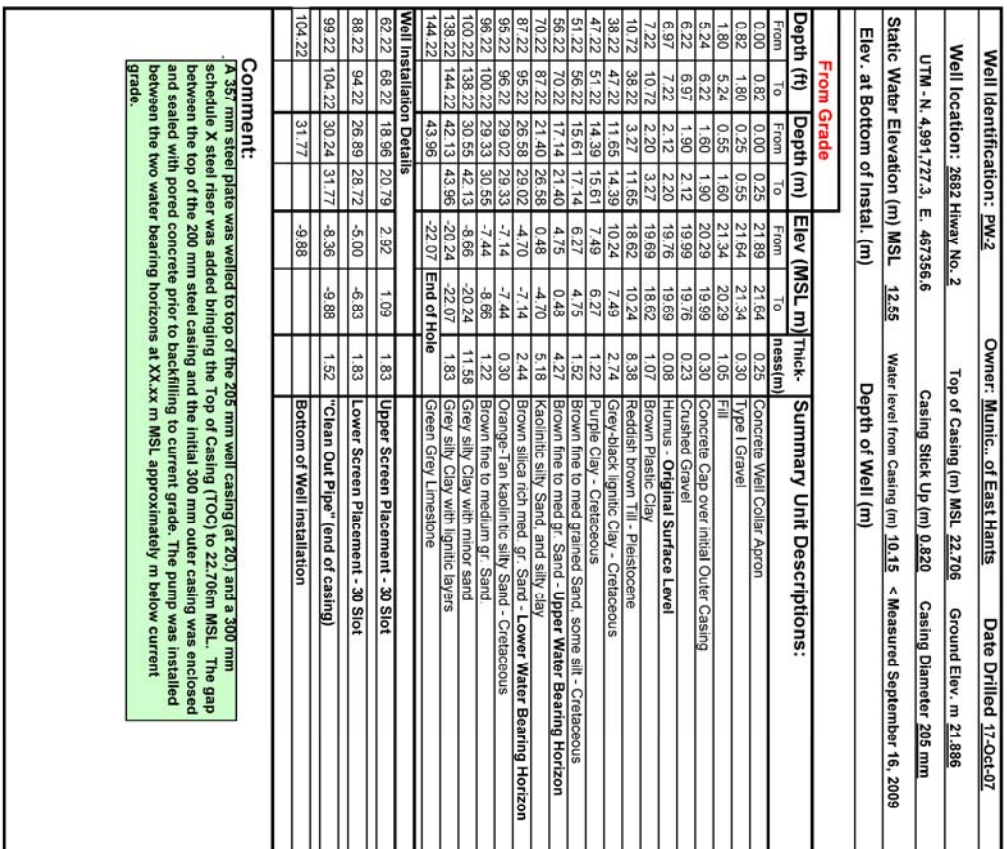
[illegible]

OTHER AREAS

- SEED
- 100mm TOPSOIL
- 100mm TYPE 1 GRAVEL SURFACE COURSE
- 200mm TYPE 2 GRAVEL BASE COURSE
- 75mm TYPE B ASPHALT
- 175mm TYPE 1 GRAVE BASE COURSE
- 200mm TYPE 2 GRAVEL SUB-BASE COURSE

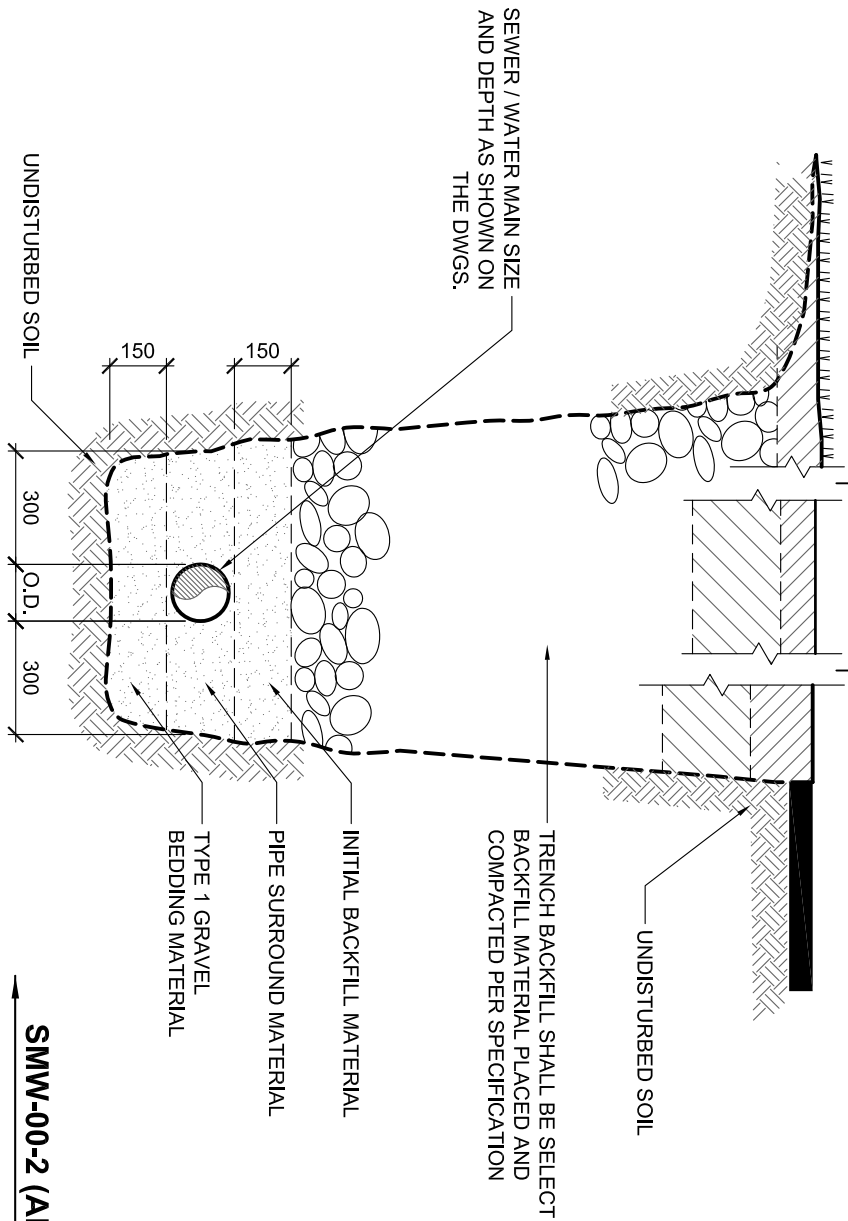

TYPICAL TRENCH DETAIL
NOT TO SCALE

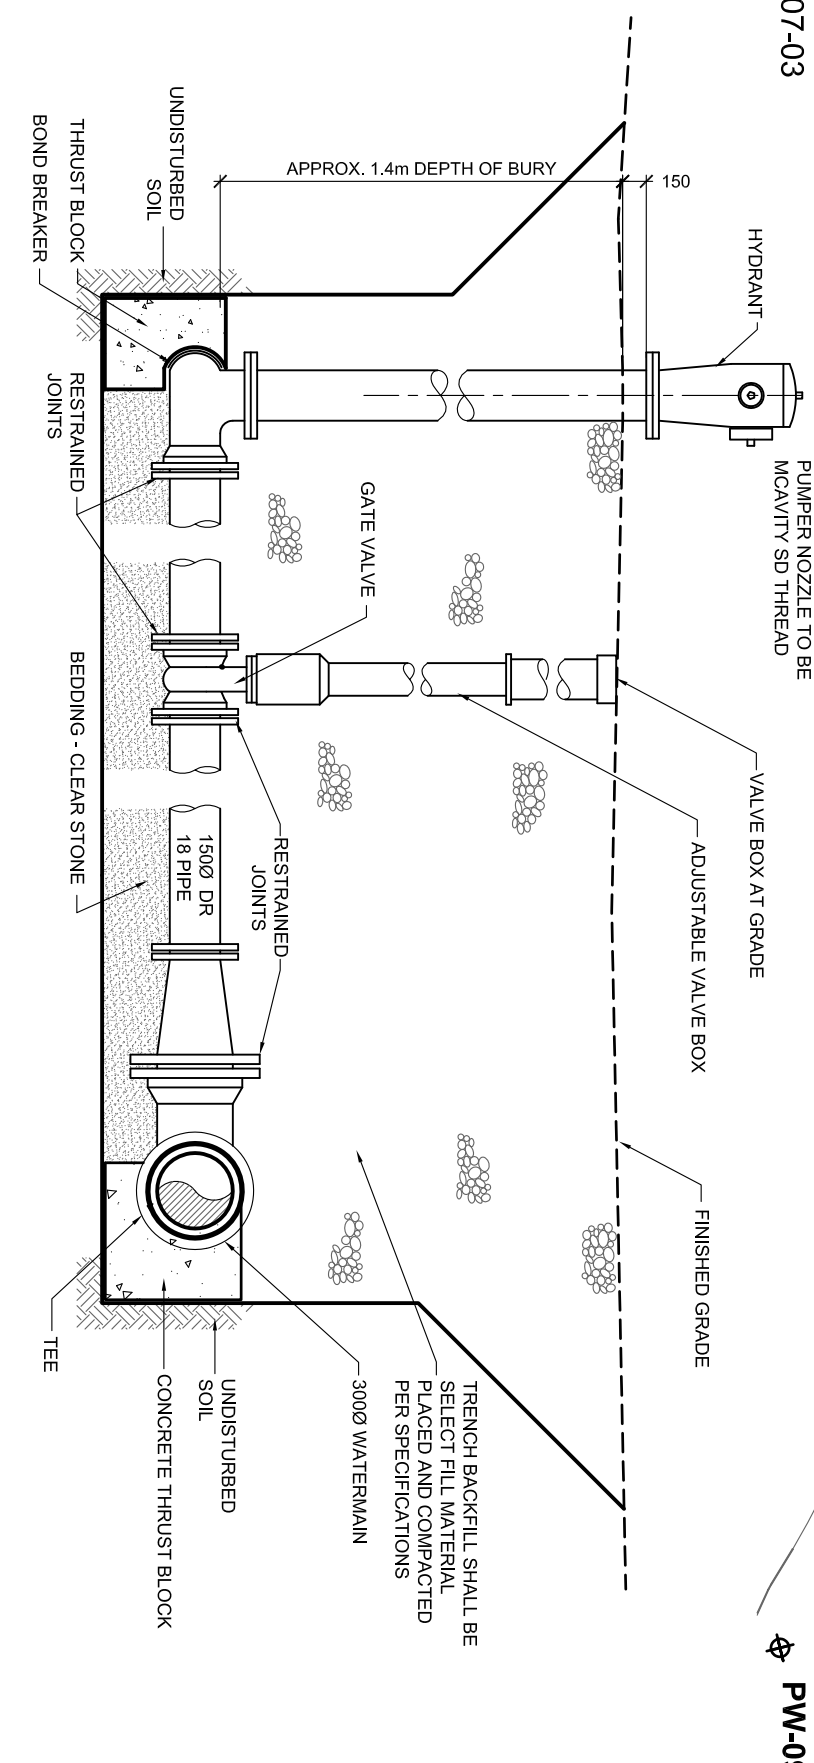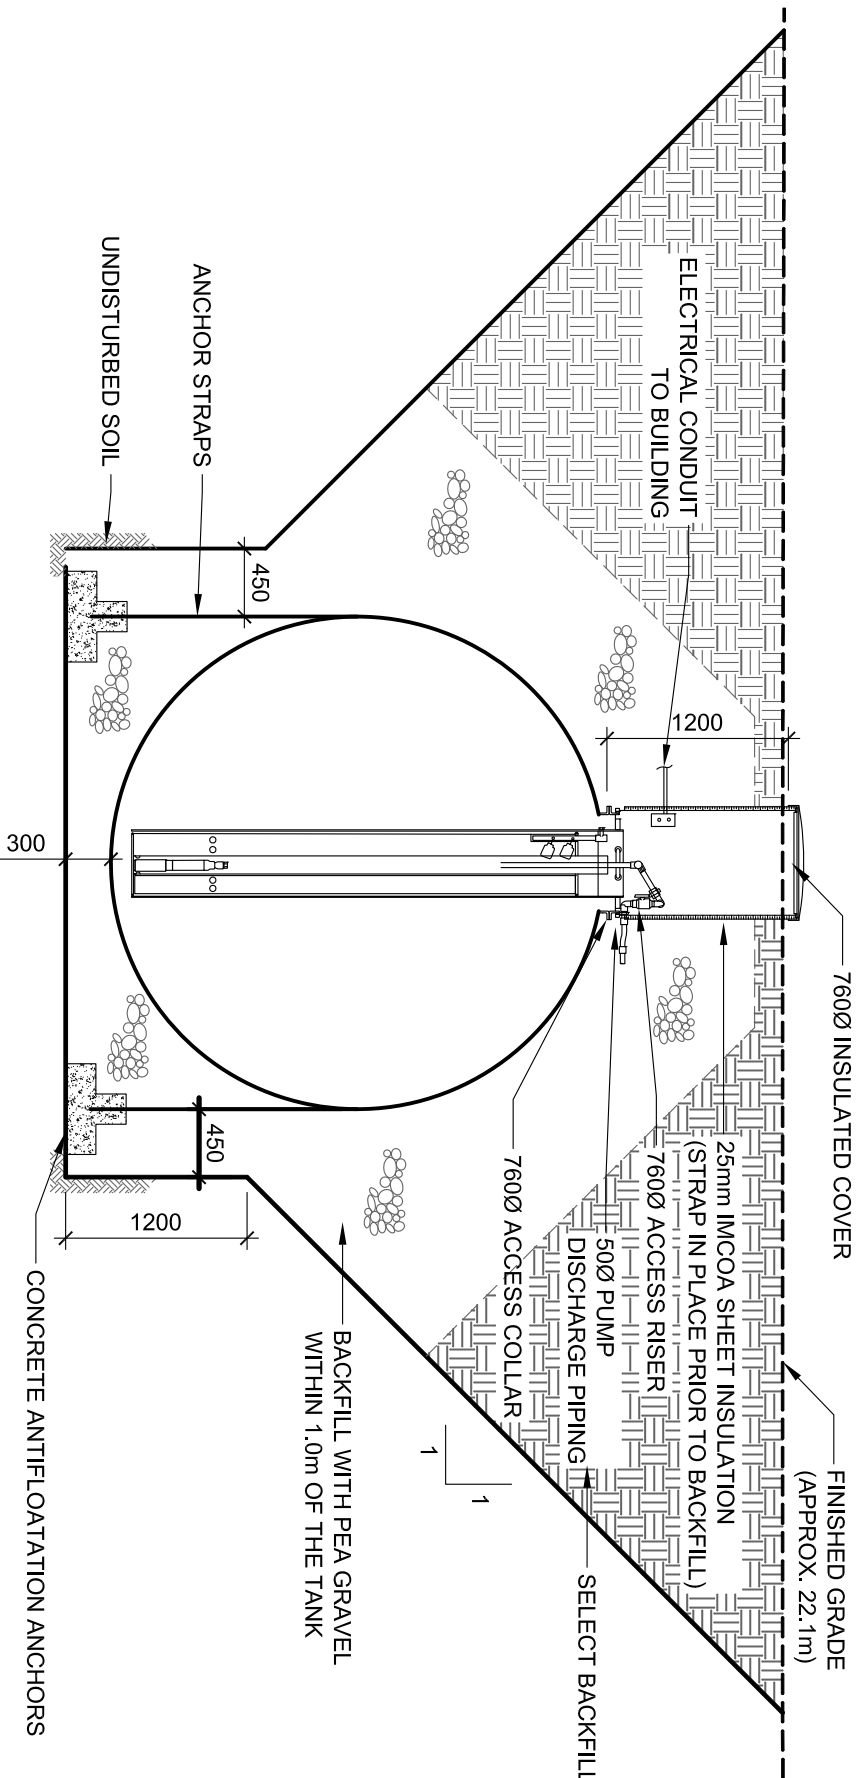

SITE SERVICES PLAN