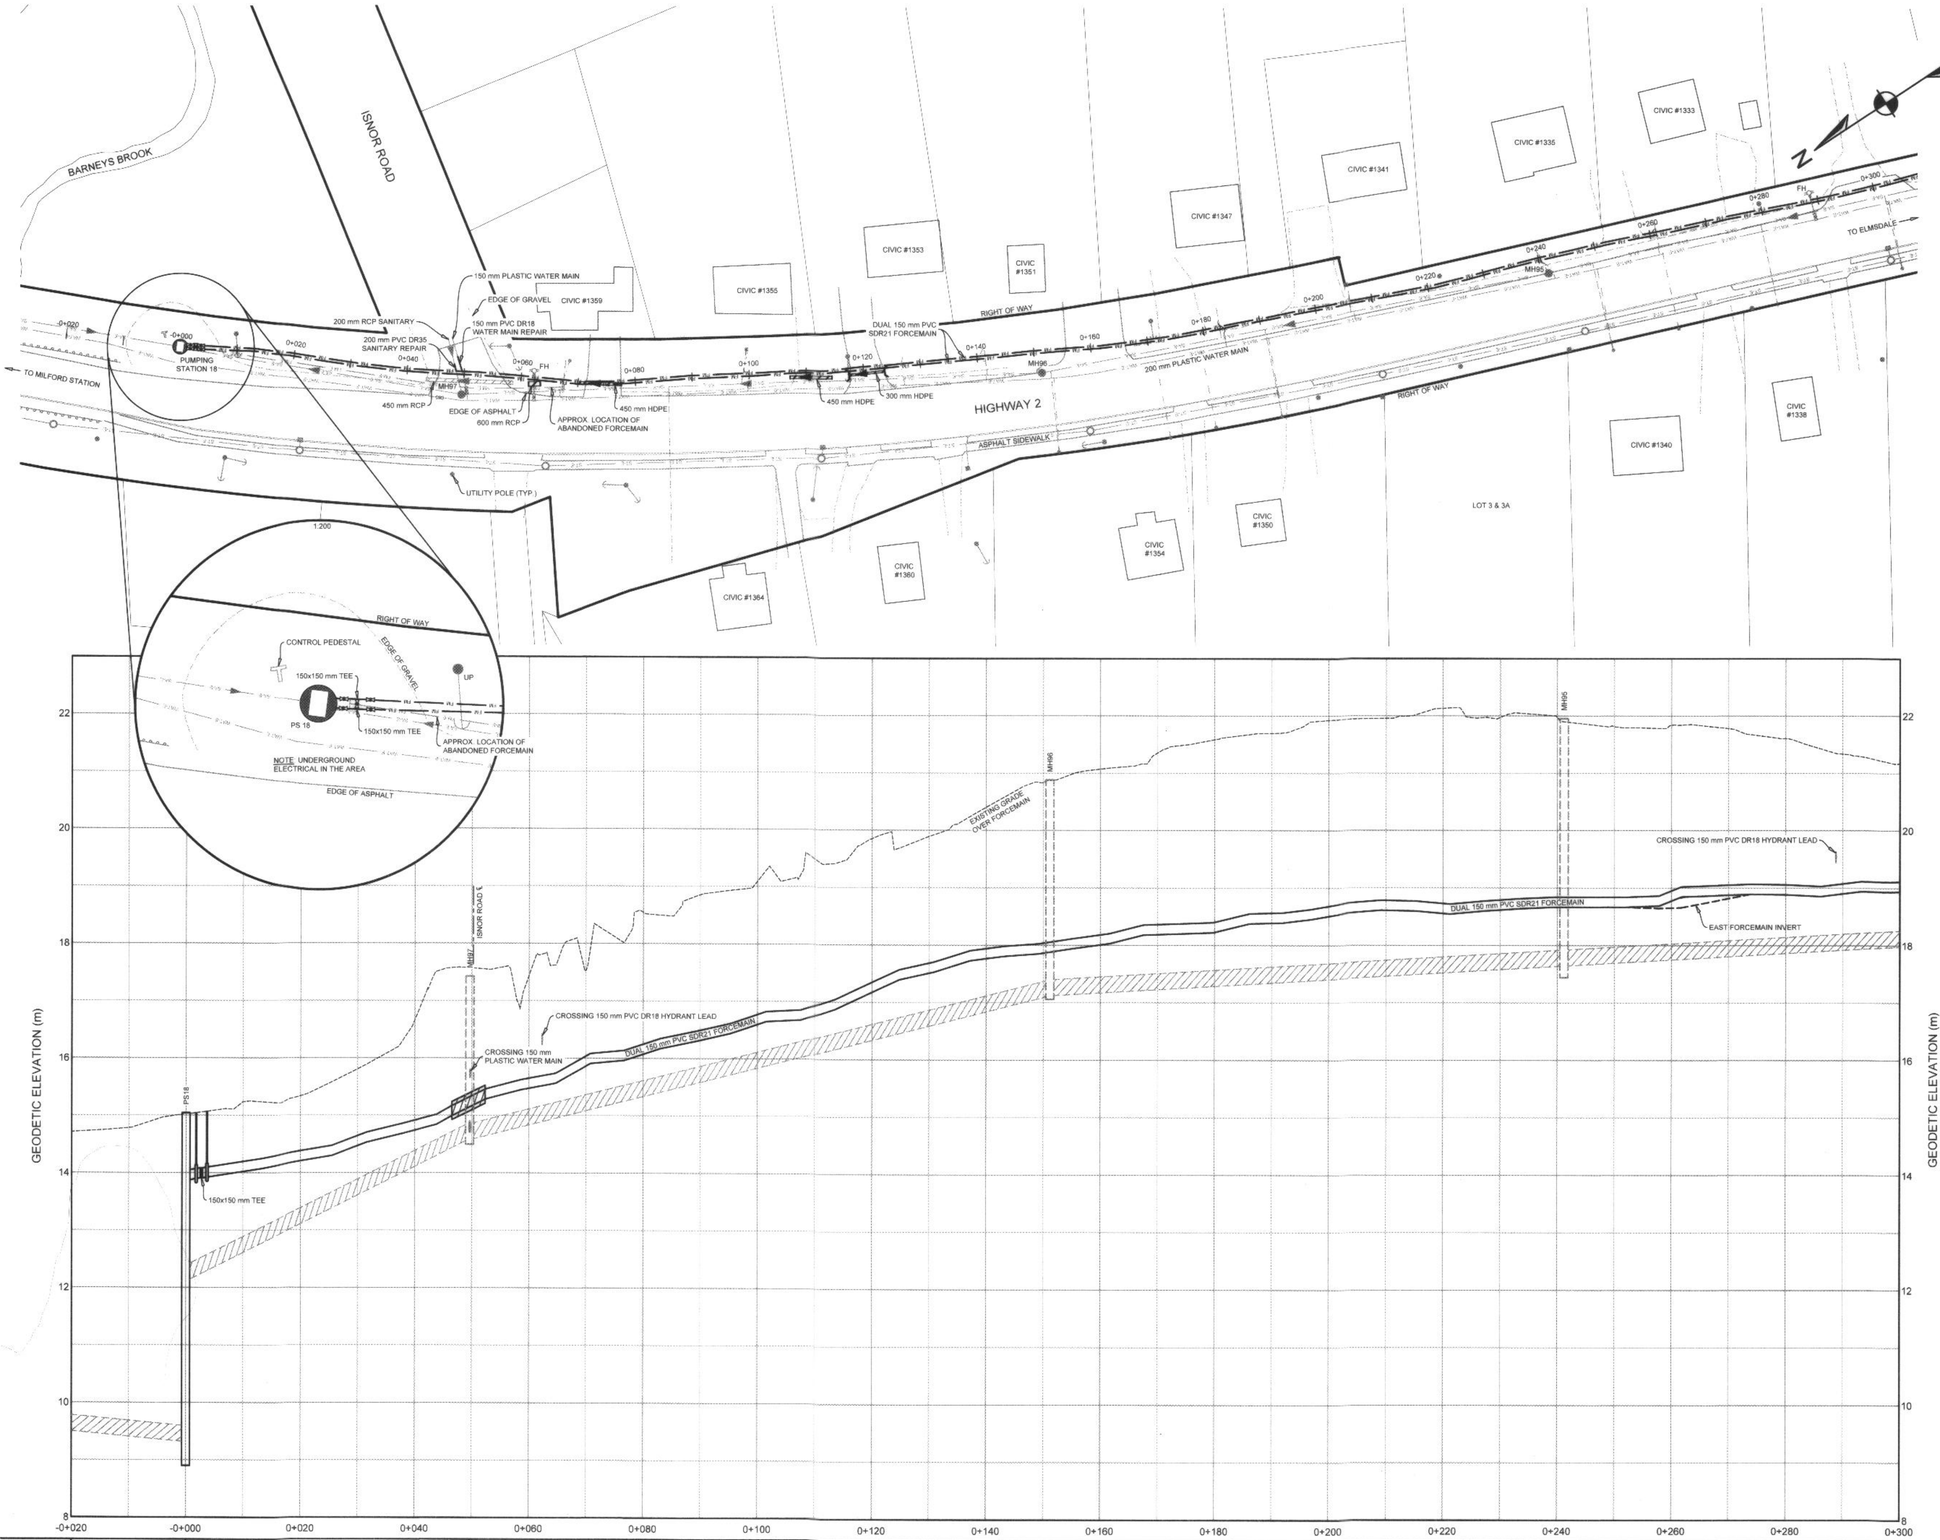

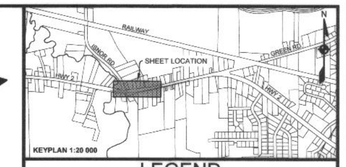

LEGEND

EXISTING		INSTALLED
	VERTICAL PROFILE	
	EASEMENT	
WAT	WATER PIPE	WAT
SA	SANITARY PIPE	SA
ST	STORM PIPE	ST
	SANITARY LATERAL	
	STORM LATERAL	
	WATER LATERAL	
	GUARDRAIL	
	TOP OF SLOPE	
	BOTTOM OF SLOPE	
OH	OVERHEAD LINE	OH
UG	UNDERGROUND LINE	UG
X	FENCELINE	X

	EXISTING	PROPOSED		EXISTING	PROPOSED
CURB CUT/RAMP			AIR RELEASE VALVE		
CURBSTOP			WATER VALVE		
REDUCER			HYDRANT		
PRECAST HEADWALL			CATCHBASIN		
STREET TREE			UTILITY POLE w/ GUY WIRE		
			STREET SIGN		

NOTE: EXISTING INFRASTRUCTURE SHOWN IS BASED ON AVAILABLE DATA.

Metres
16 0 16 32
1:500

ISSUE	DATE	DESCRIPTION
5	NOV. 22, 2019	ISSUED FOR RECORD
4	MAR. 20, 2018	ISSUED FOR CONSTRUCTION
3	NOV. 05, 2018	ISSUED FOR TENDER
2	AUG. 01, 2018	ISSUED FOR 99% REVIEW
1	JUN. 29, 2018	ISSUED FOR 50% REVIEW

CONSULTANT

DESIGN POINT
ENGINEERING & SURVEYING
PHONE: 902.832.5597 www.designpoint.ca

REGISTERED PROFESSIONAL ENGINEER — DATE NOV. 22/19 — A. J. SKETCHLEY — 11560 — PROVINCE OF NOVA SCOTIA

REGISTERED PROFESSIONAL ENGINEER — DATE NOV. 22/19 — E. TEASDALE — 9877 — PROVINCE OF NOVA SCOTIA

CLIENT

EAST HANTS

PROJECT DESCRIPTION

BARNEYS BROOK FORCEMAIN REPLACEMENT

LANTZ, NOVA SCOTIA

SHEET DESCRIPTION

HIGHWAY 2

PLAN AND PROFILE
-0+020 TO 0+300

Drawn	Engineer	Project No.	Drawing No.
L. GRANT	E. TEASDALE	18-074	2 OF 3
Date Drawn	Scale	Filename	
JUN. 29, 2019	1:500 H. 1:50 V	18-074Rec.dwg	

P:\2018\18-074 Barneys Brook Forcemain Replacement\01 - Drawings\Engineering Record Drawings\18-074Rec.dwg, Plot Date: 2019-Nov-22, Plot Size: ISO FULL BLEED A1 (594.00 X 841.00 MM)